



NOTES:

1. ALL PIPE SERIES 160 PVC UNLESS NOTED OTHERWISE. PIPE DESIGNATED HDPE IS IPS SIZED. 40mm ROAD CROSSING TYPICALLY SERIES 160 HDPE IPS UNLESS NOTED OTHERWISE.
2. ALL CURB STOPS LOCATED 1.0m OFF MAIN LINES UNLESS NOTED OTHERWISE.
3. ALL MANUAL AIR RELEASES LOCATED ON THE EDGE OF R/W AND 1.0m OFF MAIN LINES UNLESS NOTED OTHERWISE.
4. ALL FARM METER MANHOLES ARE 6 IOPM PVC MUELLER MANHOLES UNLESS NOTED OTHERWISE.
5. ALL LOCATIONS OF EXISTING LINES AND UTILITIES ARE APPROXIMATE AND FOR INFORMATION ONLY. THIS DRAWING HAS BEEN PREPARED, IN PART, BASED UPON INFORMATION PROVIDED BY OTHERS, WHILE THIS INFORMATION IS BELIEVED TO BE RELIABLE, MPE ENGINEERING LTD., THE ROCKY VIEW WATER CO-OP LTD., AND/OR ROCKY VIEW COUNTY CANNOT ASSURE ITS ACCURACY AND THUS ARE NOT RESPONSIBLE FOR THE ACCURACY OF THE RECORD DRAWING OR FOR ANY ERRORS OR OMISSIONS WHICH MAY HAVE BEEN INCORPORATED INTO IT AS A RESULT. THOSE RELYING ON THIS RECORD DOCUMENT ARE ADVISED TO OBTAIN INDEPENDENT VERIFICATION OF ITS ACCURACY BEFORE APPLYING IN FOR ANY PURPOSE.

LEGEND
 ——— TREATED WATER PIPELINE
 - - - - - RAW WATER PIPELINE

SHEET REFERENCE LEGEND

NOTE: NUMBERING SYSTEM BASED ON ROCKY VIEW COUNTY

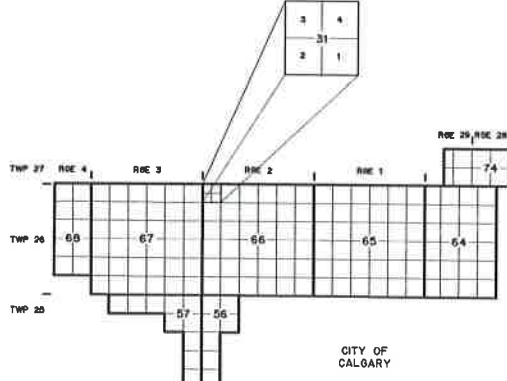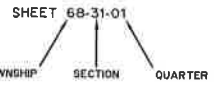

2	14-10-08	RECORD DRAWING
1	12-10-24	RECORD DRAWING
ISSUE	DATE	REVISION

PERMIT TO PRACTICE
 MPE ENGINEERING LTD.
 PERMIT NUMBER: P 3680
 The Association of Professional Engineers,
 Geologists and Geophysicists of Alberta

ORIGINAL
 SEALED BY
 DANIEL MODDERMAN
 2014-10-08



ROCKY VIEW WATER CO-OP LTD.

TREATED WATER
 DISTRIBUTION SYSTEM
 KEY PLAN

DESIGNED	R.B.	CHECKED	D.L.P.
DRAWN	R.G., J.B., J.W.	JOB	2080-004-02
SCALE	1:125 000	SHEET	
DATE	APRIL, 1994	DRAWING	